P-1639 COMMERCIAL BLUEPRINT SERVICE 4-71 456-3-

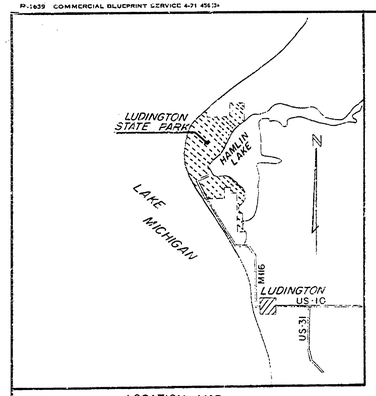

LOCATION MAP

LUDINGTON STATE PARK

CONSTRUCTION PLANS FOR

INTERPRETIVE CENTER ENTRANCE
ROAD AND PARKING
PROJECT NO. 21-9560

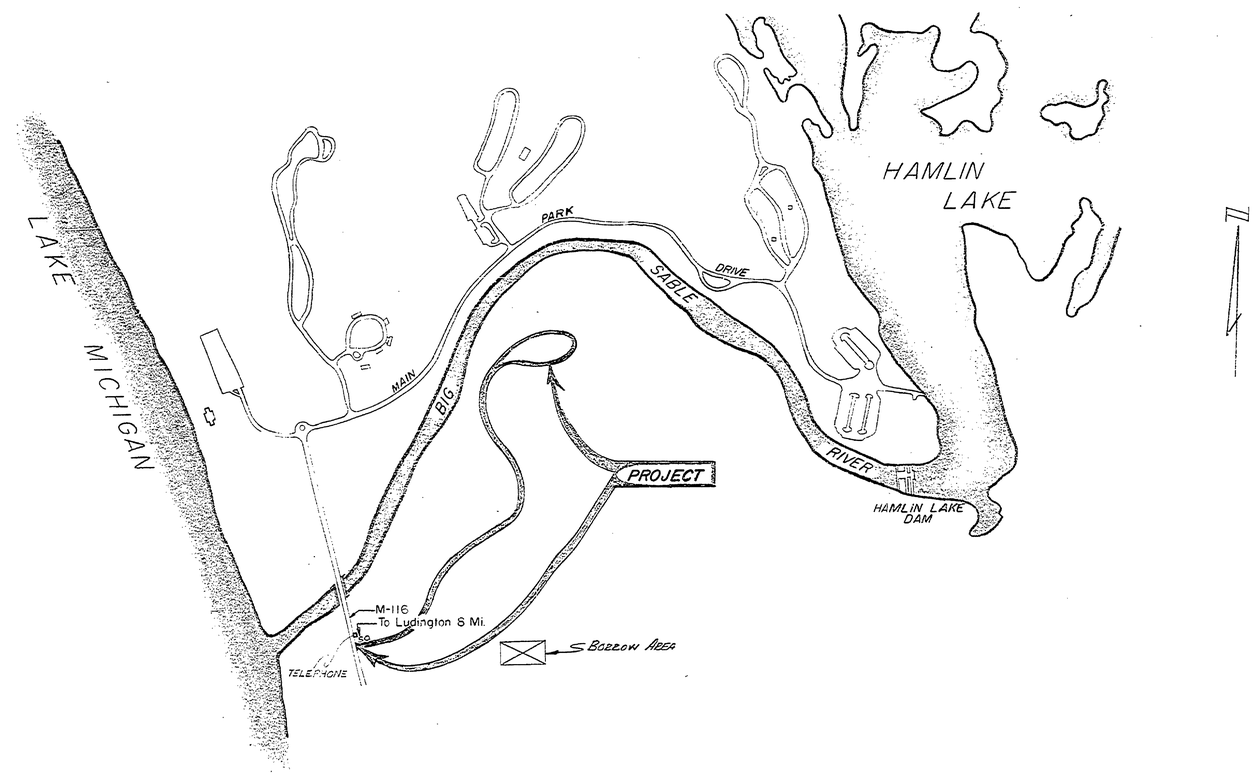

QUANTITIES

1. CUT (TO BE USED FOR FILL)	7,400 CU. YDS.
2. BORROW	6,000 CU. YDS.
3. 22 A REG. BASE COURSE	11,500 SQ. YDS.
4. BIT PAVING	10,700 SQ. YDS.

NOTE:
QUANTITIES HAVE BEEN CAREFULLY COMPUTED WITH 15% ALLOWED FOR FILL SHRINKAGE, BUT ARE NOT GUARANTEED AND ARE NOT TO BE USED FOR PAYMENT.

RE-MICROFILM

BUILDING COMMITTEE APPROVAL
BY: _____ CHAIRMAN DATE _____

RECOMMENDED FOR APPROVAL: [signature] 8-2-78
PLANNING ENGINEERING ~~OR MECHANICAL~~ SUPERVISOR DATE

RECOMMENDED FOR APPROVAL: [signature] 8/9/78
PROGRAM AND PLAN COORDINATOR DATE

DIVISION/REGION APPROVAL
BY: [signature] 11-6-78
DIVISION CHIEF ~~REGIONAL MANAGER~~ DATE

ENGINEERING DIVISION
APPROVED: [signature] 11-7-78
CHIEF ENGINEER DATE

SURVEYED BY		DRAWN BY		NO.	DATE	BY	REVISIONS	NO.	DATE	BY	REVISIONS
DESIGNED BY		CHECKED BY		1.	2-78	D.B.	WELL TELEPHONE—AS BUILT	3.			
	DATE		DATE	2.				4.			

MICHIGAN
DEPARTMENT OF NATURAL RESOURCES

COVER SHEET
SHEET TITLE

LUDINGTON STATE PARK
AREA OR PARK
INTERPRETIVE CENTER ENTRANCE ROAD AND PARKING
PROJECT

PROJECT NO. 21-9560
SHEET 1 OF 4 PLAN NO. E-137